


AIRFIELD FACILITIES	
EXISTING	
A	AIRPORT ROTATING BEACON - TOP EL. 730.6' (222.7m)
B	REIL
C	SUPPLEMENTAL LIGHTED WIND CONE
D	WEATHER RADAR ANTENNA - TOP EL. 796' (242.6m)
E	FOUR-LIGHT PAPI SYSTEM
F	AWOS-III SENSOR EQUIPMENT - TOP EL. 709.4 (216.2m)
FUTURE	
G	LIGHTED WIND TEE & SEGMENTED CIRCLE
H	SUPPLEMENTAL LIGHTED WIND CONE
I	AIR TRAFFIC CONTROL TOWER & BASE BUILDING - CAB FLOOR EL. 751' (228.9m)
J	TWO-LIGHT PAPI SYSTEM
K	FOUR-LIGHT PAPI SYSTEM
L	REIL
M	LOCALIZER ANTENNA AND SHELTER
N	GLIDE SLOPE ANTENNA AND SHELTER
O	MALS WITH RAIL
P	MIDDLE MARKER BEACON ANTENNA AND SHELTER
Q	TRANSMISSOMETER (For Touchdown RVR)
R	ODALS

	RUNWAY END COORDINATES			
	EXISTING		FUTURE	
	LATITUDE	LONGITUDE	LATITUDE	LONGITUDE
RUNWAY 9	N 41°36'28.94"	W 88°06'16.02"	N 41°36'28.94"	W 88°06'16.02"
27	N 41°36'31.08"	W 88°05'03.68"	N 41°36'31.08"	W 88°05'03.68"
RUNWAY 2R	N 41°35'57.23"	W 88°06'03.23"	N 41°35'57.23"	W 88°06'03.23"
20L	N 41°36'46.18"	W 88°06'03.23"	N 41°36'59.55"	W 88°05'43.00"
RUNWAY 2L	---	---	N 41°36'13.63"	W 88°06'10.05"
20R	---	---	N 41°36'52.03"	W 88°05'57.61"

AIRPORT DATA		
	EXISTING	FUTURE
AIRPORT CATEGORY	DESIGN GRP. II APPR. CAT. B	DESIGN GRP. III APPR. CAT. D
ESTABLISHED AIRPORT ELEVATION ABOVE MEAN SEA LEVEL (AMSL)	679.5' (207.1m) AMSL	679.5' (207.1m) AMSL
MEAN MAX. TEMP. - HOTTEST MONTH	87.7° F	87.7° F
AIRPORT REFERENCE POINT (ARP) (NAD83)	LAT. N 41° 36' 30" LONG. W 88° 05' 40"	LAT. N 41° 36' 30" LONG. W 88° 05' 51"
TAXIWAY FACILITIES	CENTERLINE MARKING, MITL LIGHTING, GUIDANCE SIGNS	SAME
TERMINAL NAVIGATION AIDS	SUPPL. WIND CONES, AWOS-III, OFF-FIELD VORTAC, 36" BEACON	EXISTING PLUS LTD. WIND TEE, SEC. CIRCLE, ATCT
FEE SIMPLE LAND AREA (Acres)	606.9	1,152.6
AVIGATION EASEMENT AREA (Acres)	1.0	36.1

RUNWAY DATA					
	EXISTING RUNWAY 9/27	FUTURE RUNWAY 9/27	EXISTING RUNWAY 2/20	FUTURE RUNWAY 2R/20L	FUTURE RUNWAY 2L/20R
AIRPLANE DESIGN GROUP	II WINGSPAN LESS THAN 79' (24m)	II WINGSPAN LESS THAN 79' (24m)	III WINGSPAN LESS THAN 118' (36m)	III WINGSPAN LESS THAN 118' (36m)	II WINGSPAN LESS THAN 79' (24m)
AIRCRAFT APPROACH CATEGORY	B SPEED LESS THAN 121 KNOTS	D SPEED LESS THAN 166 KNOTS	D SPEED LESS THAN 166 KNOTS	D SPEED LESS THAN 166 KNOTS	B SPEED LESS THAN 121 KNOTS
CRITICAL AIRCRAFT (DESIGN GROUP, APPROACH CATEGORY & TAIL HEIGHT)	BEECH KING AIR B200 TAIL HEIGHT - 15.0' (4.6m)	GULFSTREAM IV TAIL HEIGHT - 24.4' (7.4m)	GULFSTREAM 550 TAIL HEIGHT - 25.8' (7.9m)	GULFSTREAM 550 TAIL HEIGHT - 25.8' (7.9m)	BEECH KING AIR B200 TAIL HEIGHT - 15.0' (4.6m)
PRECISION INSTRUMENT RUNWAY	9, 27-NONPRECISION	9-NONPRECISION, 3/4 MILE 27-NONPRECISION, 1 MILE	NONE	2R	NONE
PART 77 APPROACH SLOPE	9-20:1, 27-20:1	9-34:1, 27-20:1	2-20:1, 20-20:1	2R-50:1, 20L-20:1	2L-20:1, 20R-20:1
PART 77 APPROACH SURFACE DIMENSIONS (TO 50 FOOT CLEAR) (INNER WIDTH x LENGTH x OUTER WD.)	9-500'x1000'x800' (150m x 300m x 244m) 27-500'x1000'x800' (150m x 300m x 244m)	9-1000'x1700'x1510' (300m x 510m x 453m) 27-500'x1700'x1010' (150m x 300m x 210m)	2-500'x1000'x700' (150m x 300m x 210m) 20-500'x1000'x700' (150m x 300m x 210m)	2R-1000'x2500'x1750' (300m x 762m x 533m) 20L-1000'x1000'x1100' (300m x 300m x 335m)	2L-250'x1000'x450' (76m x 300m x 137m) 20R-250'x1000'x450' (76m x 300m x 137m)
RUNWAY PROTECTION ZONE (R.P.Z.) DIMENSIONS (INNER WIDTH x LENGTH x OUTER WD.)	9-500'x1000'x700' (150m x 300m x 210m) 27-500'x1000'x700' (150m x 300m x 210m)	9-1000'x1700'x1510' (300m x 510m x 453m) 27-500'x1700'x1010' (150m x 300m x 210m)	2-500'x1700'x1010' (150m x 300m x 210m) 20-500'x1700'x1010' (150m x 300m x 210m)	2R-1000'x2500'x1750' (300m x 750m x 525m) 20L-500'x1700'x1010' (150m x 300m x 303m)	2L-500'x1000'x700' (150m x 300m x 210m) 20R-500'x1000'x700' (150m x 300m x 210m)
RUNWAY LENGTH & WIDTH	5,697'x75' * (1,736m x 23m)	5500'x100' (1,676m x 30m)	5100'x100' (1,554m x 30m)	6500'x100' (1,983m x 30m)	4000'x75' (1,220m x 23m)
RUNWAY SAFETY AREA (R.S.A.) LENGTH & WIDTH	300'x150' (90m x 45m)	1000'x500' (300m x 150m)	1000'x500' (300m x 150m)	1000'x500' (300m x 150m)	300' x 150' (90m x 45m)
OBJECT FREE AREA (O.F.A.) LENGTH & WIDTH	300'x500' (90m x 150m)	1000'x800' (300m x 240m)	1000'x800' (300m x 240m)	1000'x800' (300m x 240m)	300'x500' (90m x 150m)
EFFECTIVE RUNWAY GRADIENT	0.149%	0.125%	0.324%	0.254%	0.100%
EFFECTIVE RUNWAY LENGTH	5612' (1,711m)	5431' (1,655m)	4935' (1,504m)	6335' (1,931m)	3960' (1,208m)
PAVEMENT TYPE & STRENGTH	ASPHALT 24,000 lbs. SWG	PAVED 75,000 lbs. DWG	CONCRETE 99,000 lbs. DWG	CONCRETE 99,000 lbs. DWG	PAVED 12,500 lbs. SWG
RUNWAY MARKING	NONPRECISION WITH FIXED DIST. MKRS.	NONPRECISION WITH FIXED DIST. MKRS.	NONPRECISION	PRECISION	BASIC
RUNWAY LIGHTING	MIRL	MIRL	MIRL	HIRL	MIRL
VISUAL NAVIGATION AIDS	9-REIL, PAPI-4	9-ODALS, PAPI-4 27-REIL, PAPI-4	2-REIL, PAPI-4 20-REIL, PAPI-4	2R-MALS, PAPI-4 20L-REIL, PAPI-4	2L & 20R-PAPI-2
ELECTRONIC NAVIGATION AIDS	NONE	9-LOCALIZER APPROACH	NONE	2R-CATEGORY I PRECISION	NONE
TRUE RUNWAY AZIMUTH	N87°44'02.4"E	N87°44'02.4"E	N13°43'59"E	N13°43'59"E	N13°44'02.4"E
PERCENT WIND COVERAGE	83.1% (10.5 knot)	97.0% (16 knot)	98.4% (16 knot)	98.4% (16 knot)	88.9% (10.5 knot)

* DISPLACED BY 197'

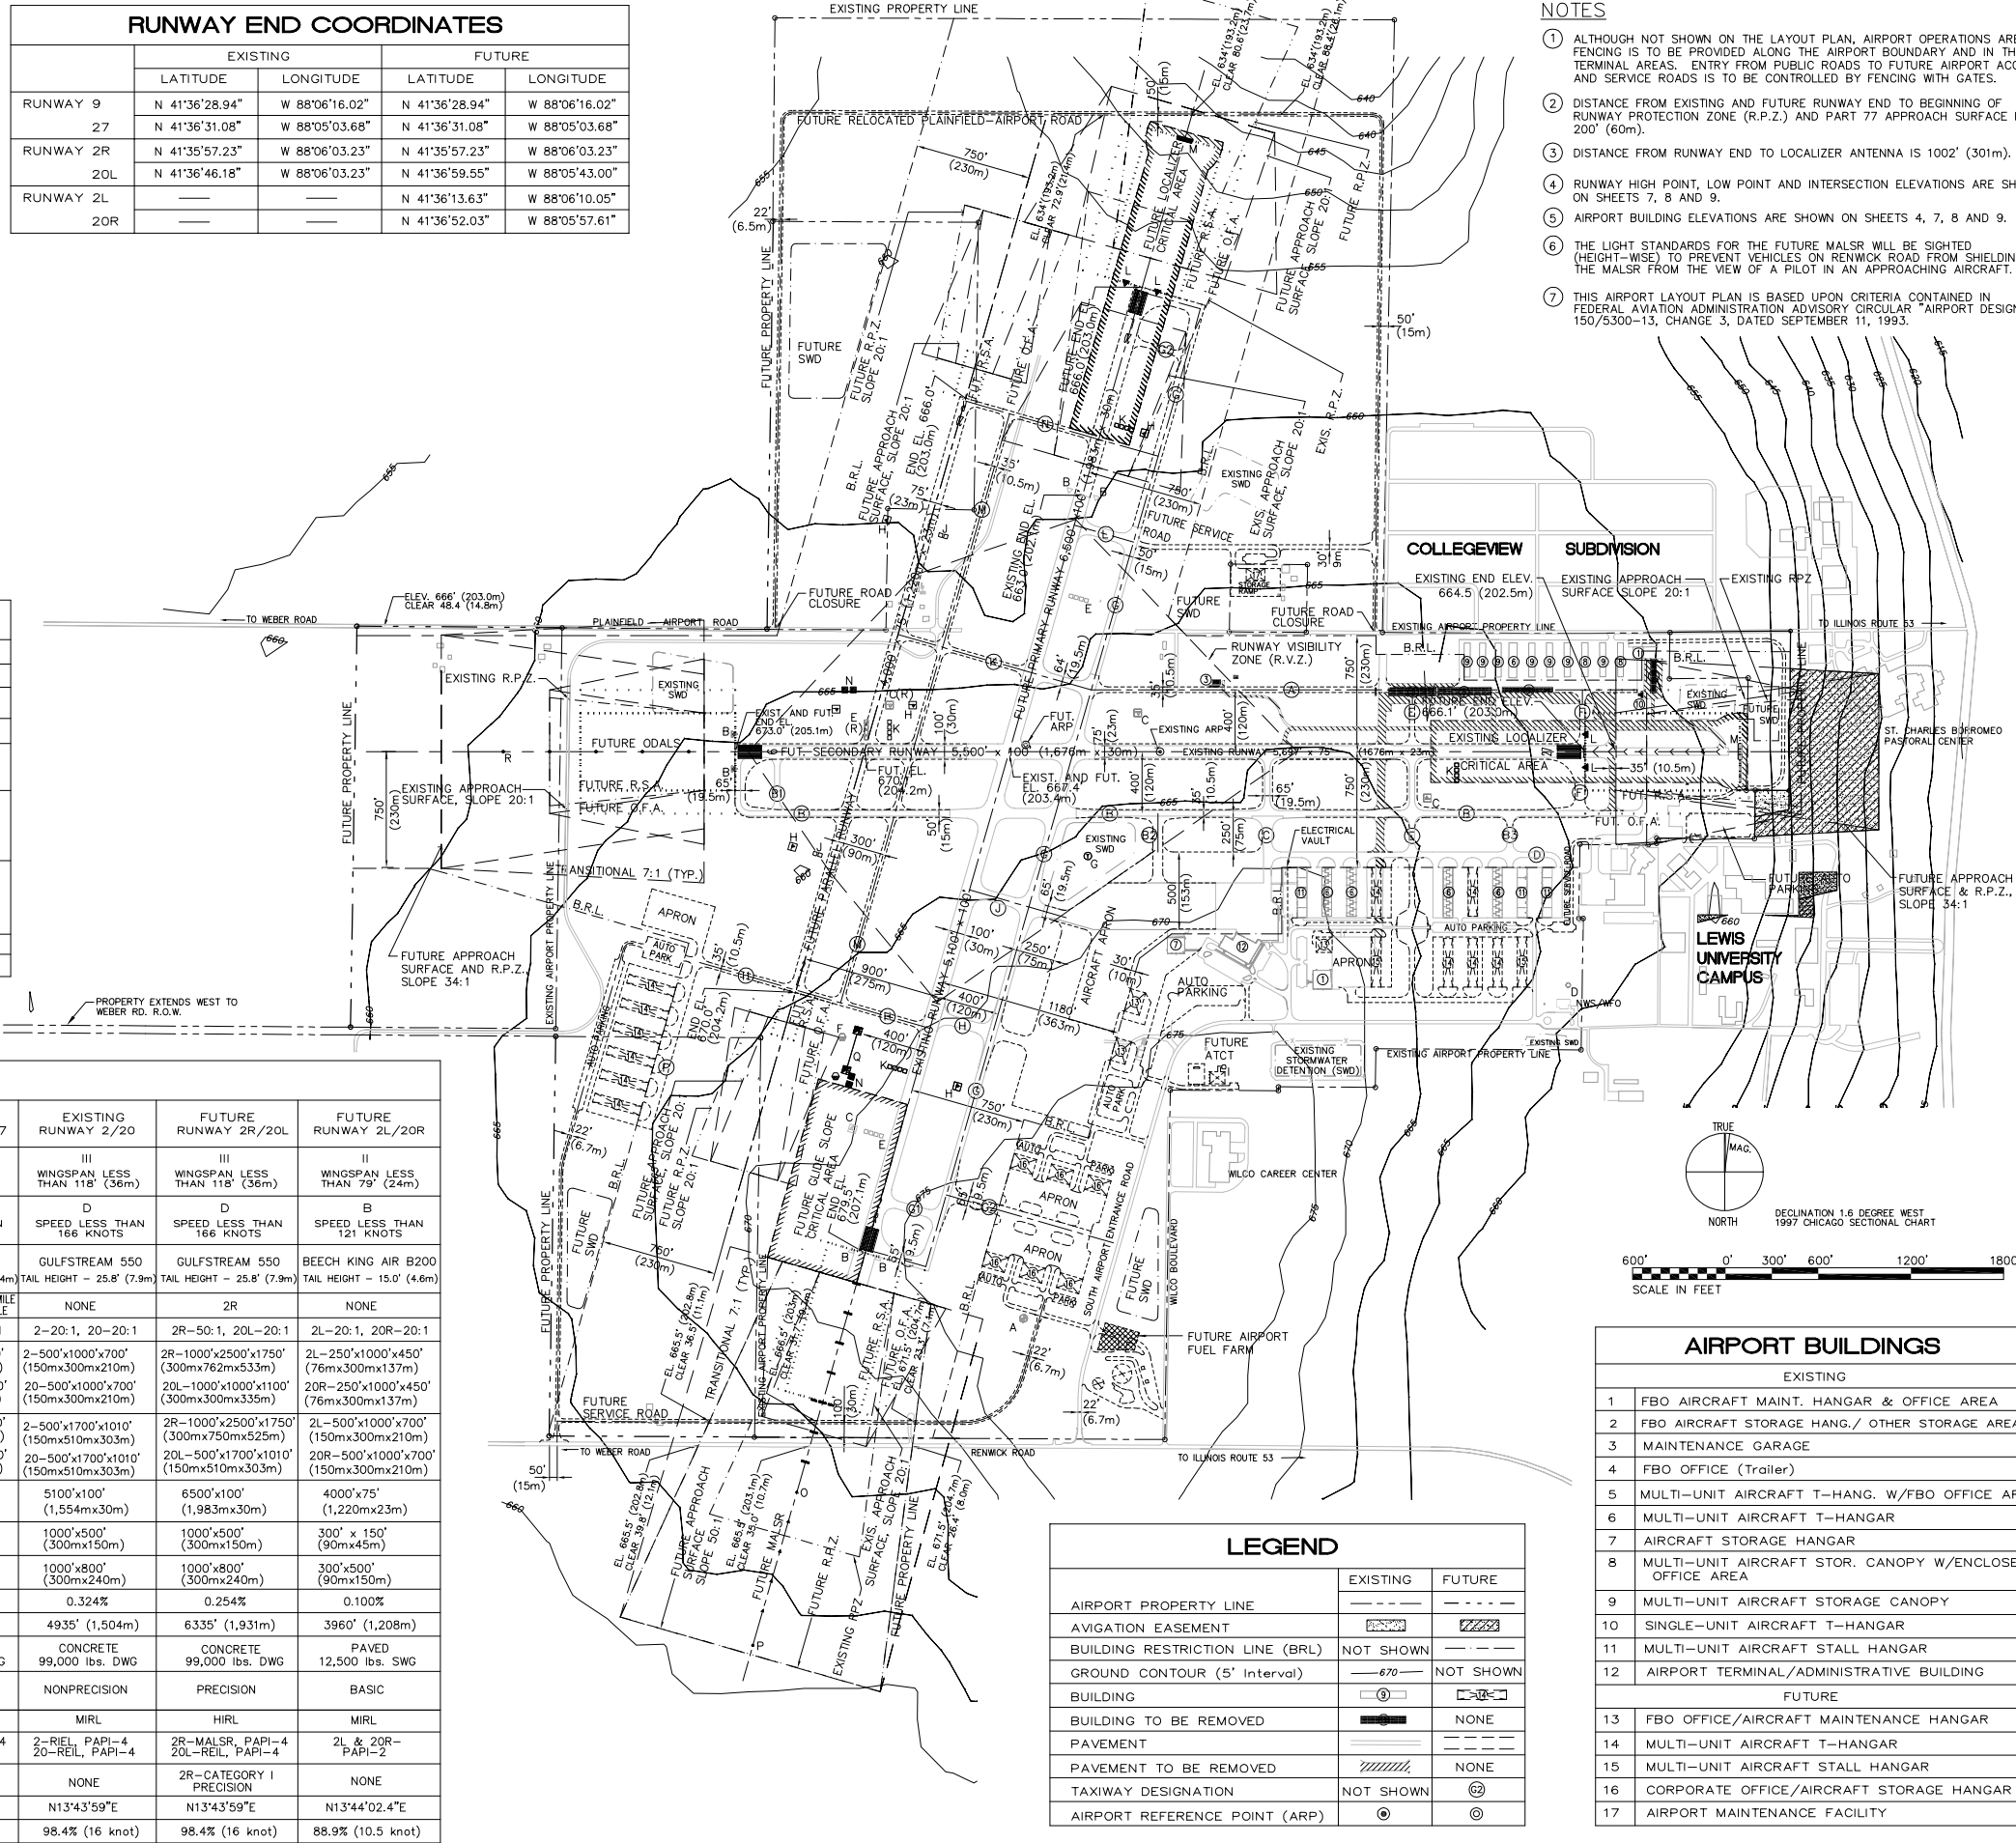

- NOTES**
- ALTHOUGH NOT SHOWN ON THE LAYOUT PLAN, AIRPORT OPERATIONS AREA FENCING IS TO BE PROVIDED ALONG THE AIRPORT BOUNDARY AND IN THE TERMINAL AREAS. ENTRY FROM PUBLIC ROADS TO FUTURE AIRPORT ACCESS AND SERVICE ROADS IS TO BE CONTROLLED BY FENCING WITH GATES.
 - DISTANCE FROM EXISTING AND FUTURE RUNWAY END TO BEGINNING OF RUNWAY PROTECTION ZONE (R.P.Z.) AND PART 77 APPROACH SURFACE IS 200' (60m).
 - DISTANCE FROM RUNWAY END TO LOCALIZER ANTENNA IS 1002' (301m).
 - RUNWAY HIGH POINT, LOW POINT AND INTERSECTION ELEVATIONS ARE SHOWN ON SHEETS 7, 8 AND 9.
 - AIRPORT BUILDING ELEVATIONS ARE SHOWN ON SHEETS 4, 7, 8 AND 9.
 - THE LIGHT STANDARDS FOR THE FUTURE MALS WILL BE SIGHTED (HEIGHT-WISE) TO PREVENT VEHICLES ON RENWICK ROAD FROM SHIELDING THE MALS FROM THE VIEW OF A PILOT IN AN APPROACHING AIRCRAFT.
 - THIS AIRPORT LAYOUT PLAN IS BASED UPON CRITERIA CONTAINED IN FEDERAL AVIATION ADMINISTRATION ADVISORY CIRCULAR "AIRPORT DESIGN", 150/5300-13, CHANGE 3, DATED SEPTEMBER 11, 1993.

HANSON PROFESSIONAL SERVICES INC.

815 Commerce Drive, Suite 200
Oak Brook, Illinois 60523
Telephone: 630.990.3800
Fax: 630.990.3801

JOLIET REGIONAL PORT DISTRICT

1 Hangar Road
Romeoville, Illinois 60446
Telephone: 815.838.9497
Fax: 815.838.9524

AIRPORT LAYOUT PLAN UPDATE

No.	Drawing	Issue	Description	Date	By
5	As Built	IDA LOT-3133 & 3294		4/26/2005	TMM
4	As Built	IDA 95A-16-1958		3/1/1998	RMH
3	As Built	Runway 9 Approach		12/1/1997	TMM
2	Runway 27	Threshold Relocation		2/26/1996	RMH
1	FAA Airspace Review	(3/28/1995)		4/27/1995	RMH

AIRPORT BUILDINGS			
EXISTING			
1	FBO AIRCRAFT MAINT. HANGAR & OFFICE AREA		
2	FBO AIRCRAFT STORAGE HANG./ OTHER STORAGE AREA		
3	MAINTENANCE GARAGE		
4	FBO OFFICE (Trailer)		
5	MULTI-UNIT AIRCRAFT T-HANG. W/FBO OFFICE AREA		
6	MULTI-UNIT AIRCRAFT T-HANGAR		
7	AIRCRAFT STORAGE HANGAR		
8	MULTI-UNIT AIRCRAFT STOR. CANOPY W/ENCLOSED OFFICE AREA		
9	MULTI-UNIT AIRCRAFT STORAGE CANOPY		
10	SINGLE-UNIT AIRCRAFT T-HANGAR		
11	MULTI-UNIT AIRCRAFT STALL HANGAR		
12	AIRPORT TERMINAL/ADMINISTRATIVE BUILDING		
FUTURE			
13	FBO OFFICE/AIRCRAFT MAINTENANCE HANGAR		
14	MULTI-UNIT AIRCRAFT T-HANGAR		
15	MULTI-UNIT AIRCRAFT STALL HANGAR		
16	CORPORATE OFFICE/AIRCRAFT STORAGE HANGAR		
17	AIRPORT MAINTENANCE FACILITY		

LEGEND		
	EXISTING	FUTURE
AIRPORT PROPERTY LINE	---	---
AVIGATION EASEMENT	▨	▨
BUILDING RESTRICTION LINE (BRL)	NOT SHOWN	---
GROUND CONTOUR (5' Interval)	---670---	NOT SHOWN
BUILDING	⊙	⊙
BUILDING TO BE REMOVED	■	NONE
PAVEMENT	---	---
PAVEMENT TO BE REMOVED	▨	NONE
TAXIWAY DESIGNATION	NOT SHOWN	⊙
AIRPORT REFERENCE POINT (ARP)	⊙	⊙

FUTURE AIRPORT LAYOUT PLAN

840-03D8036

Project Number
TMM ---
Layout By Date

RMH ---
Designed By Date

TMM ---
Reviewed By Date

TMM ---
Drawn By

Sheet No.

I:\PROJECTS\LEWIS\ALP UPDATES 2005-1\ALP REVISION 2005-1.DWG MAY 20, 2005 9:38AM RMH